


Lot Service Card

86 DEERBORNE DR
 LOT 198, NEP14725, DISTRICT LOT 3512,



Folio Number: 517-02503.394

PID: 010-207-040

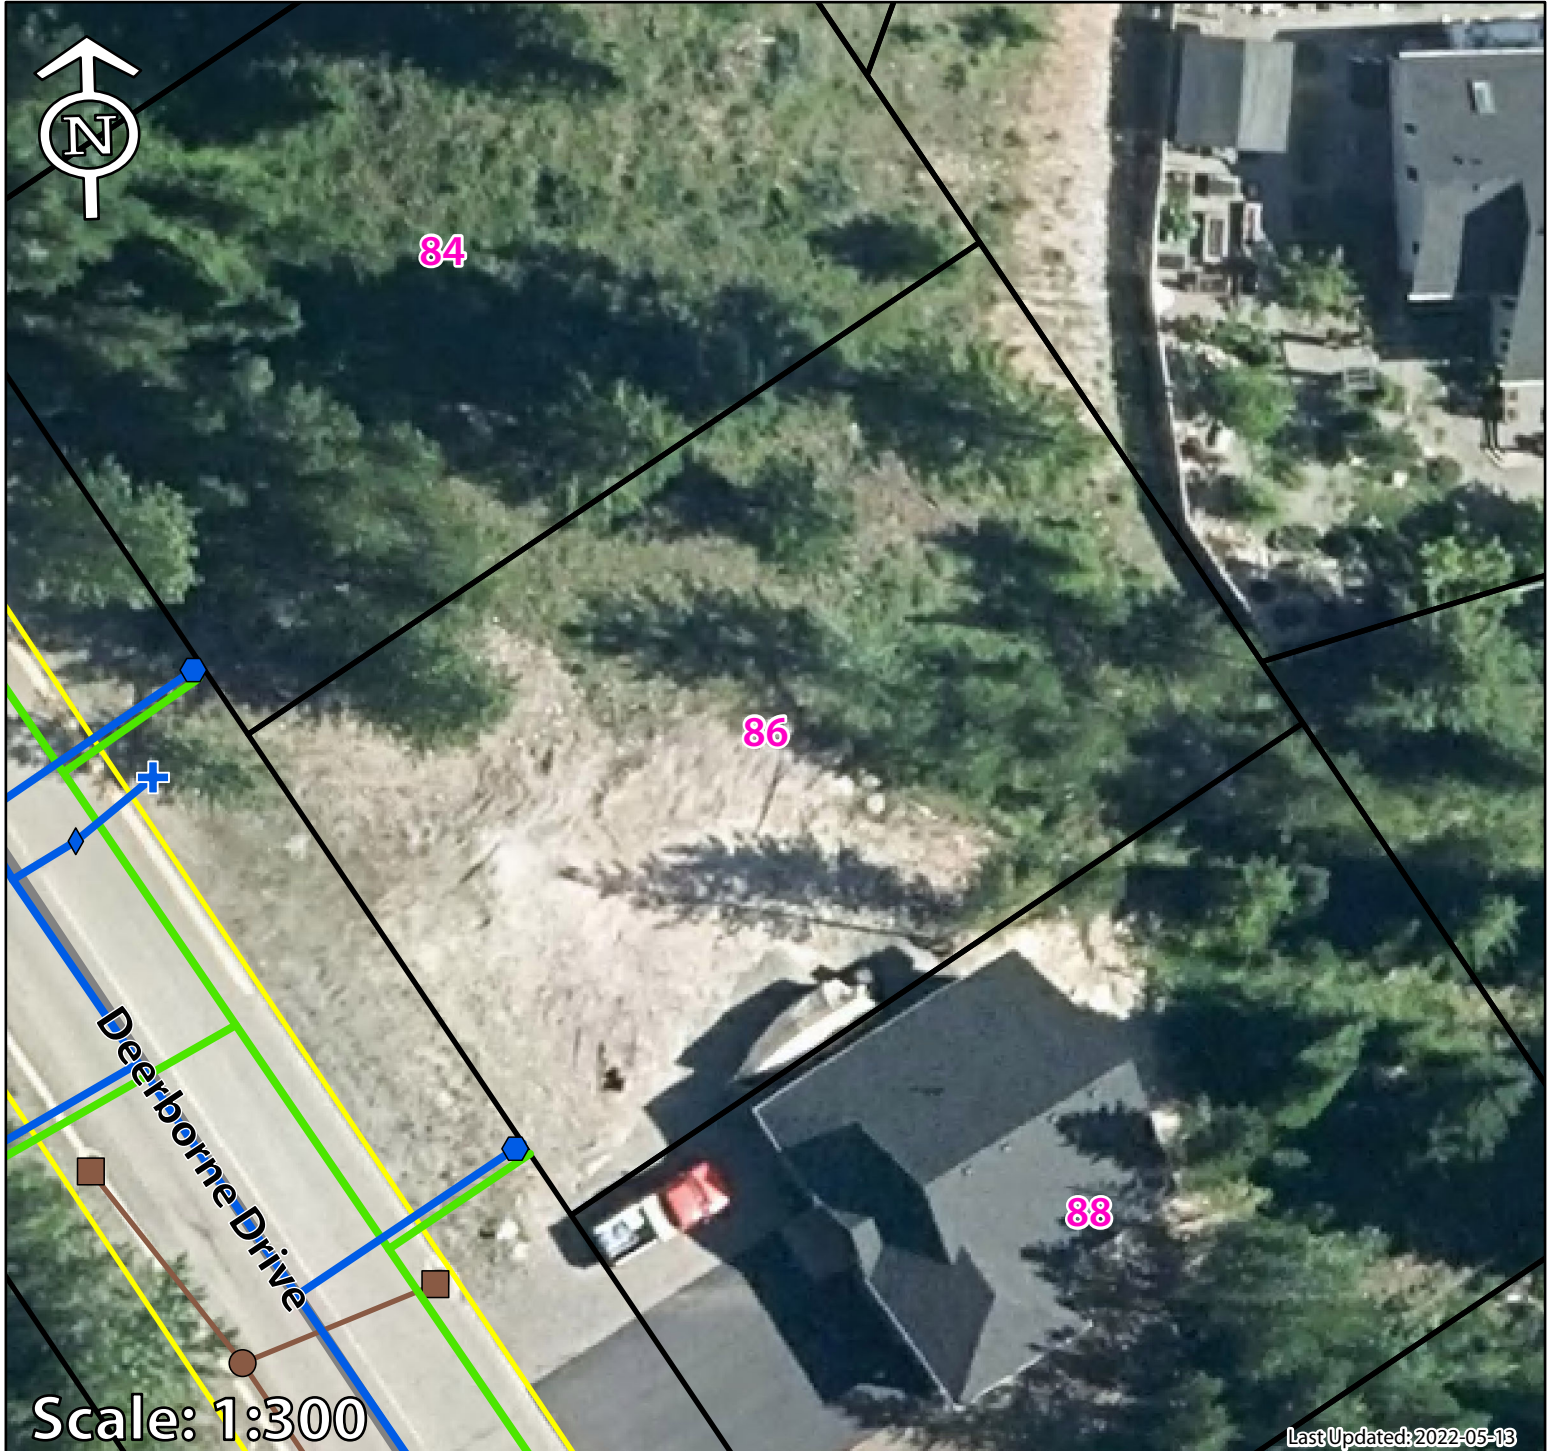

— Storm Main	■ Water Building	● Sanitary Manhole
● Storm Manhole	+ Water Hydrant	● Sanitary Cleanout
■ Storm Catchbasin	◆ Water Valve	— Gas Line
— Water Main	▲ Water Well	□ Right of Way
● Water Curbstops	— Sanitary Main	— Roads
		□ Parcel Boundary

Water Details	Installation Year:	Sanitary Details	Installation Year:
Material: Cu	1982	Material: Scepter	1982
Size: 19 (mm)	Depth: N/A (m)	Size: 100 (mm)	Depth: N/A (m)

This document is provided as general information only for your convenience. The information contained herein has not been created, nor verified, by the District of Elkford and is not warranted nor represented to be fully accurate or correct. You may not rely ONLY on the information contained herein as being accurate or correct for any purpose. Measurements displayed are approximate and any user should confirm on site prior to making any decisions about the property.

For more information:
 Phone: **250.865.4000** Email: info@elkford.ca